Vedlegg D-1

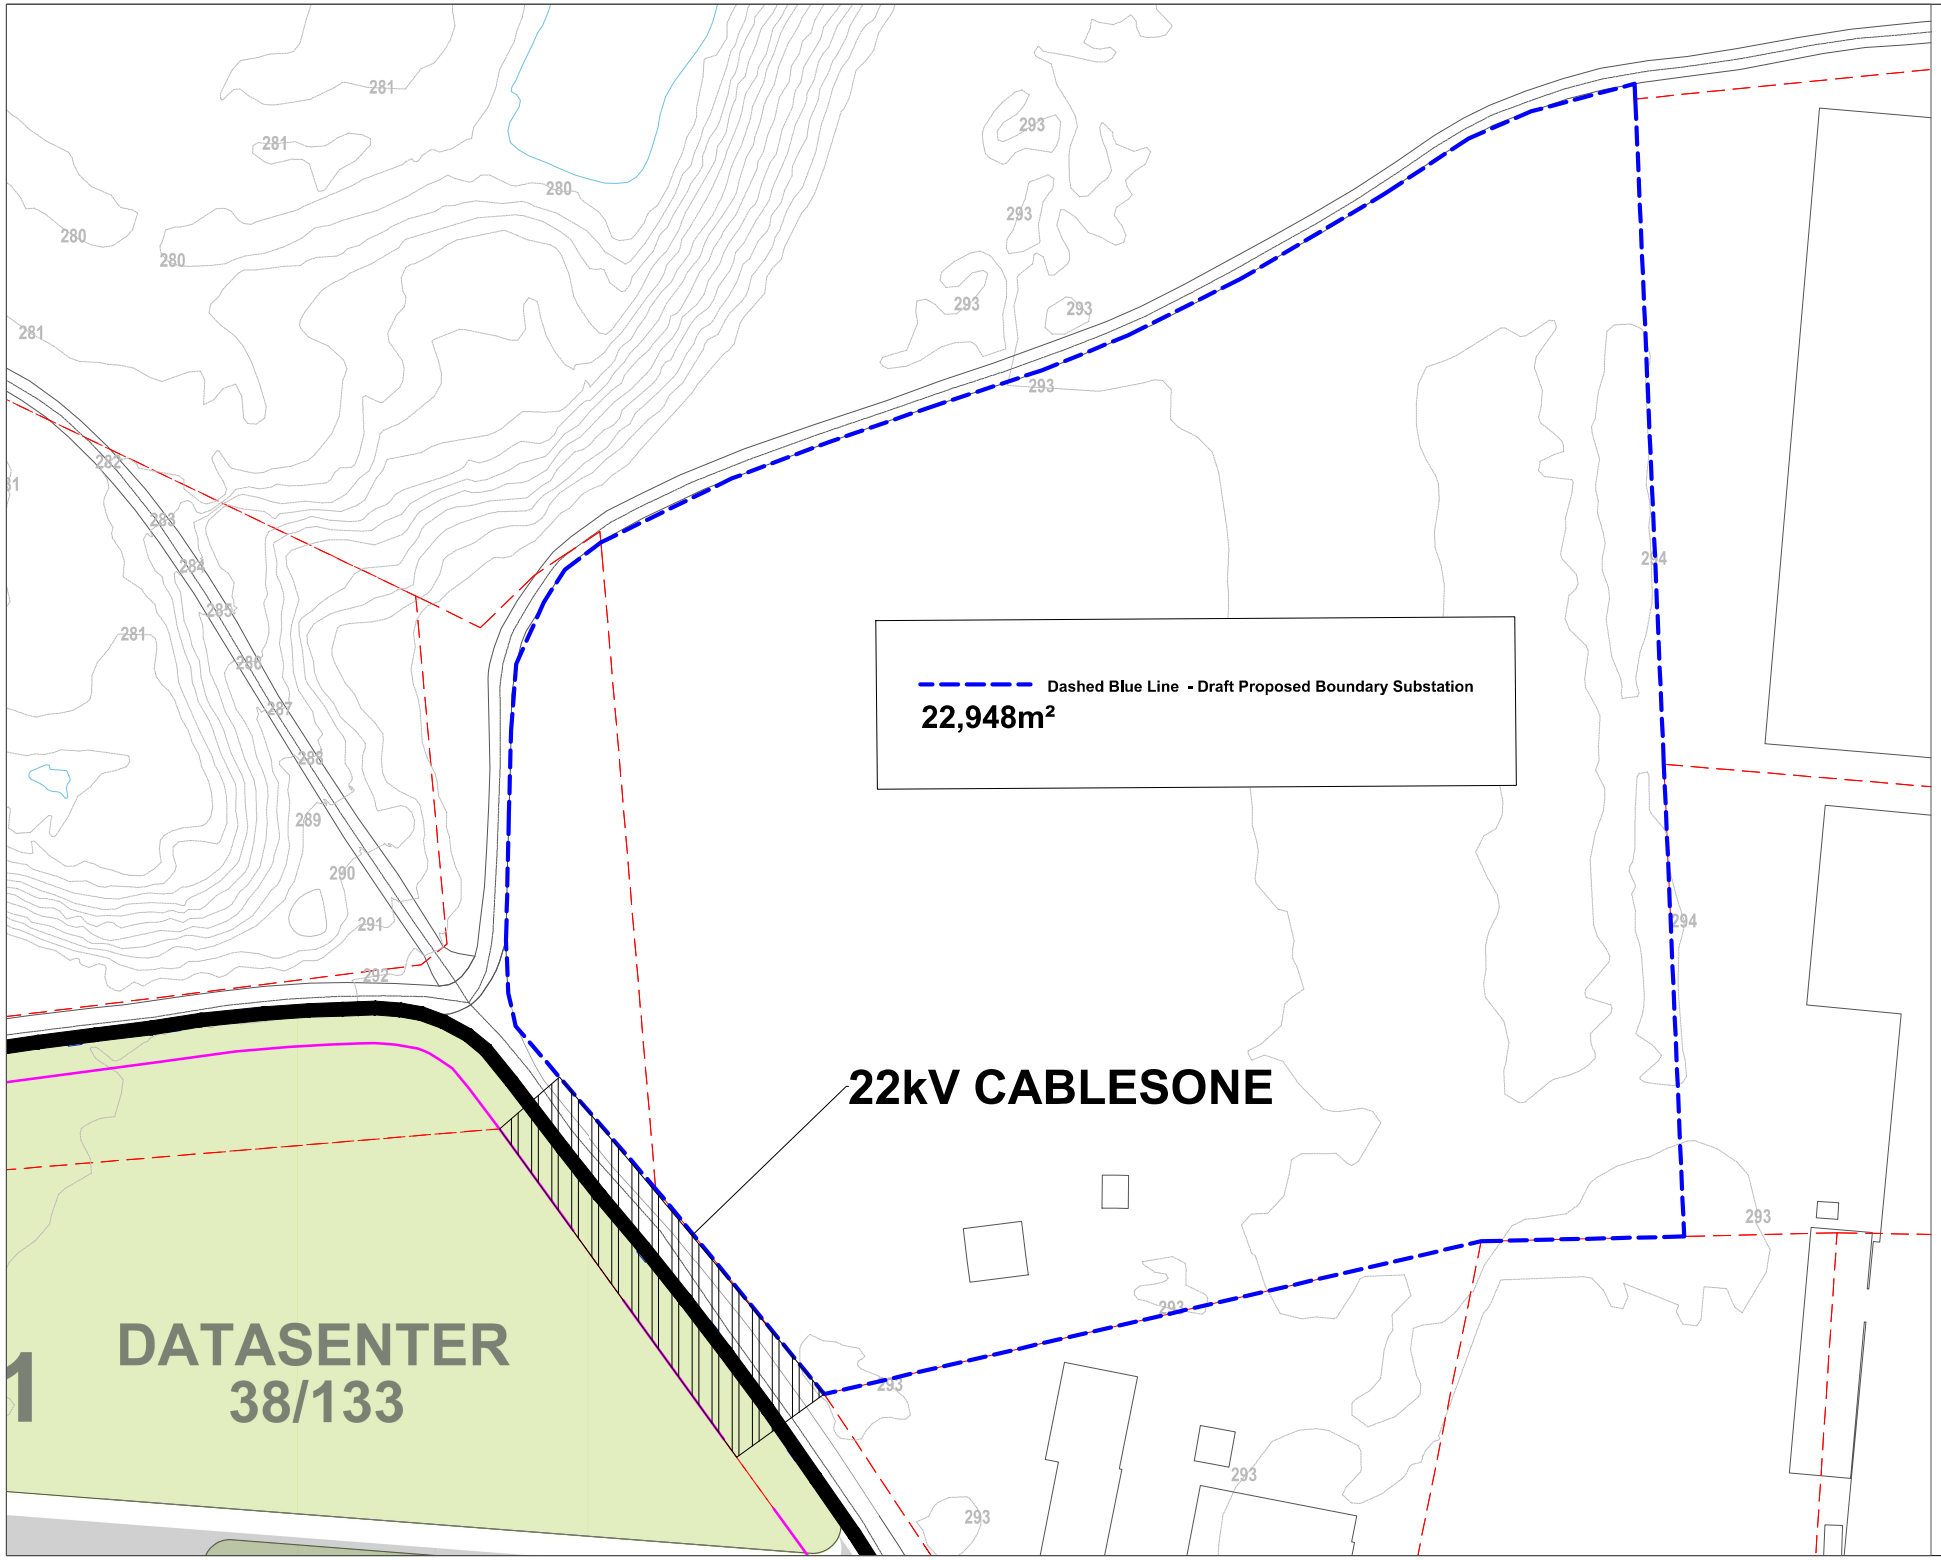

EIENDOMSGRENSE
BESTEMMELSESGRENSE
SIKKERHETSGJERDE
BYGNINGER
TEKNISKE ANLEGG
GRØNTAREAL
SERVICEAREALER
VEIER OG PARKERINGSAREAL

All dimensions must be checked & control on-site before production,This plan is only valid in connection with the plans of the specialist engineers, as well as all detailed plans of the architect. Company details and execution drawings are only valid with the above note of the architect.

DESIGN & BUILD CONTRACTOR:
CTS

CLIENT:
EDGECONNEX

CONSULTANT:
BCEI

PROJECT:
EDGECONNEX FYRESDAL

DRAWING NAME:
SITUASJONSKART - MARKUP FOR SUBSTATION BOUNDARY

PROJECT PHASE:		SCALE:	STATUS:
REAL ESTATE PLANNING		1 : 1000	-
DATE CREATED: 26-03-2025	LAST REV. DATE: 26-03-2025	DRAWN: RB	CONTROL: RB
DRAWING NUMBER: DR-:-10100		FORMAT: A0	REVISION: 00